



2 FIRST LEVEL FLOOR PLAN
SCALE: 3/16" = 1'-0"

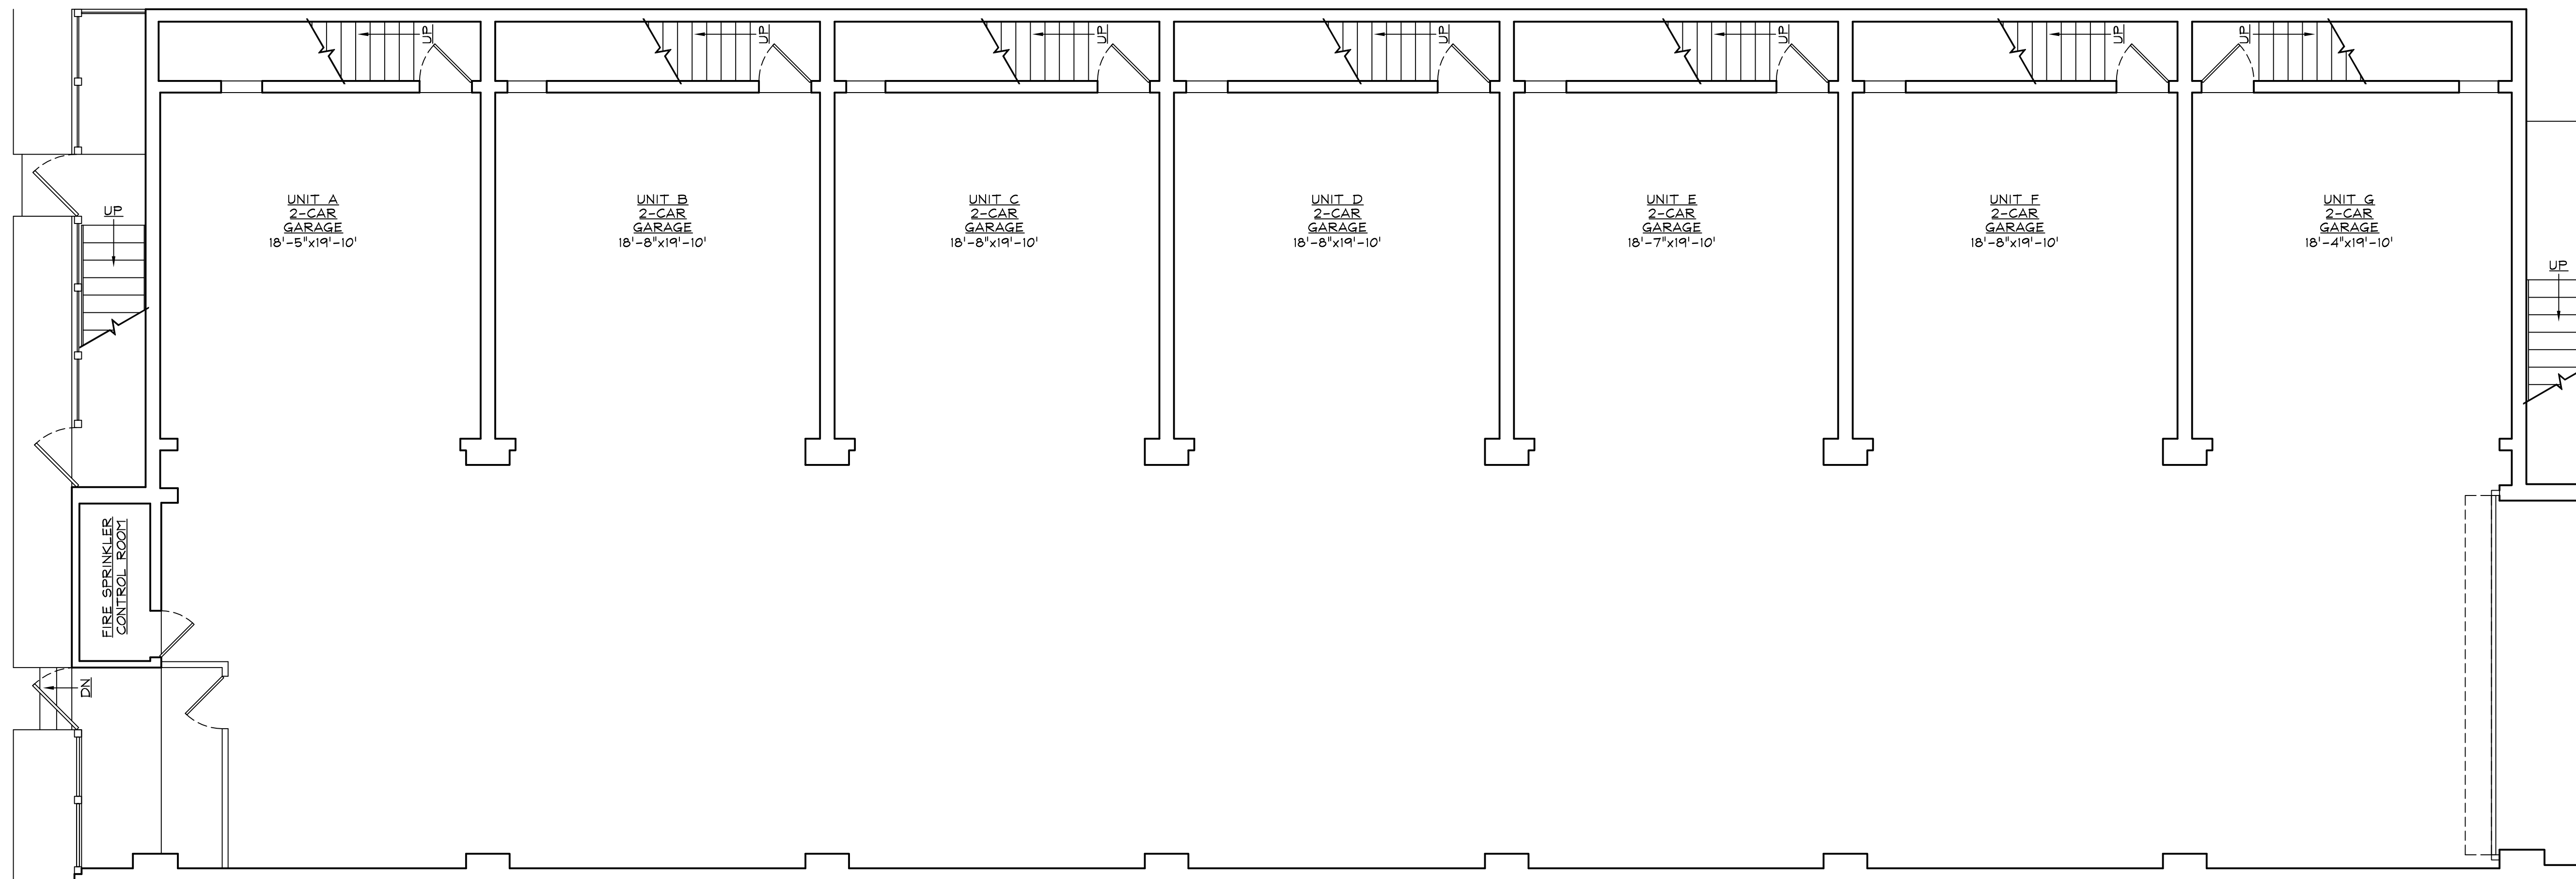

1 GARAGE LEVEL FLOOR PLAN
SCALE: 3/16" = 1'-0"

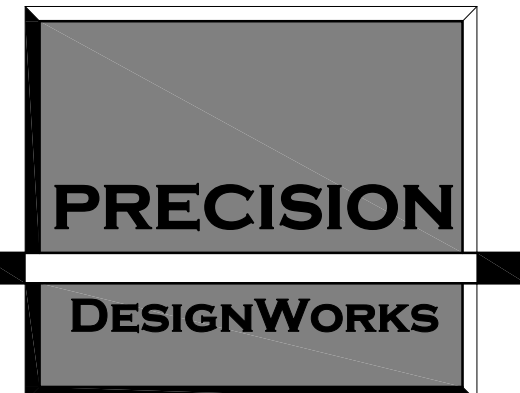


PRECISION DESIGNWORKS, LLC.
4265 HAWTHORNE DRIVE
BROOMFIELD, COLORADO 80020
T: 303.819.1833

NOTICE: DUTY OF COOPERATION
Release of these plans contemplates further cooperation among the owner, his contractor and the architect. Design and construction are complex. Although the architect and his consultants have performed their services with due care and diligence, they cannot guarantee perfection. Communication is imperfect, and every contingency cannot be anticipated. Any ambiguity or discrepancy discovered by the use of these plans shall be reported immediately to the architect. Failure to notify the architect compounds misunderstanding and increases construction costs. A failure to cooperate by a simple notice to the architect shall relieve the architect from responsibility for all consequences. Changes made from the plans without consent of the architect are unauthorized, and shall relieve the architect of responsibility for all consequences arising out of such changes.
All drawn and written information appearing herein shall not be duplicated, disclosed or otherwise used without the written consent of Precision DesignWorks, LLC.

**3040 ZUNI STREET
TOWNHOMES
DENVER, CO 80211**
AS-BUILT DOCUMENTATION

CURRENT ISSUE
AS-BUILTS - 02/22/2010

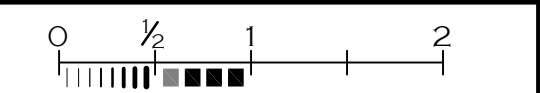

PROJECT NUMBER

0906

SHEET TITLE

GARAGE &
FIRST LEVEL
FLOORPLANS

©2010 PRECISION DESIGNWORKS, LLC.

SHEET NUMBER


A1.0

FEBRUARY 22, 2010

NOTICE: DUTY OF COOPERATION
Release of these plans contemplates further cooperation among the owner, his contractor and the architect. Design and construction are complex. Although the architect and his consultants have performed their services with due care and diligence, they cannot guarantee perfection. Communication is imperfect, and every contingency cannot be anticipated. Any ambiguity or discrepancy discovered by the use of these plans shall be reported immediately to the architect. Failure to notify the architect compounds misunderstanding and increases construction costs. A failure to cooperate by a simple notice to the architect shall relieve the architect from responsibility for all consequences. Changes made from the plans without consent of the architect are unauthorized, and shall relieve the architect of responsibility for all consequences arising out of such changes.
All drawn and written information appearing herein shall not be duplicated, disclosed or otherwise used without the written consent of Precision DesignWorks, LLC.

3040 ZUNI STREET
TOWNHOMES
DENVER, CO 80211
AS-BUILT DOCUMENTATION


CURRENT ISSUE
AS-BUILTS - 02/22/2010

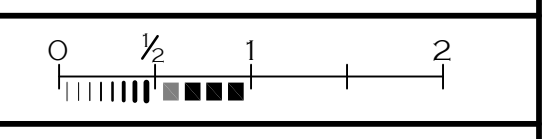


PROJECT NUMBER
0906
SHEET TITLE
SECOND & THIRD LEVEL FLOORPLANS

©2010 PRECISION DESIGNWORKS, LLC.

SHEET NUMBER
A2.0
FEBRUARY 22, 2010

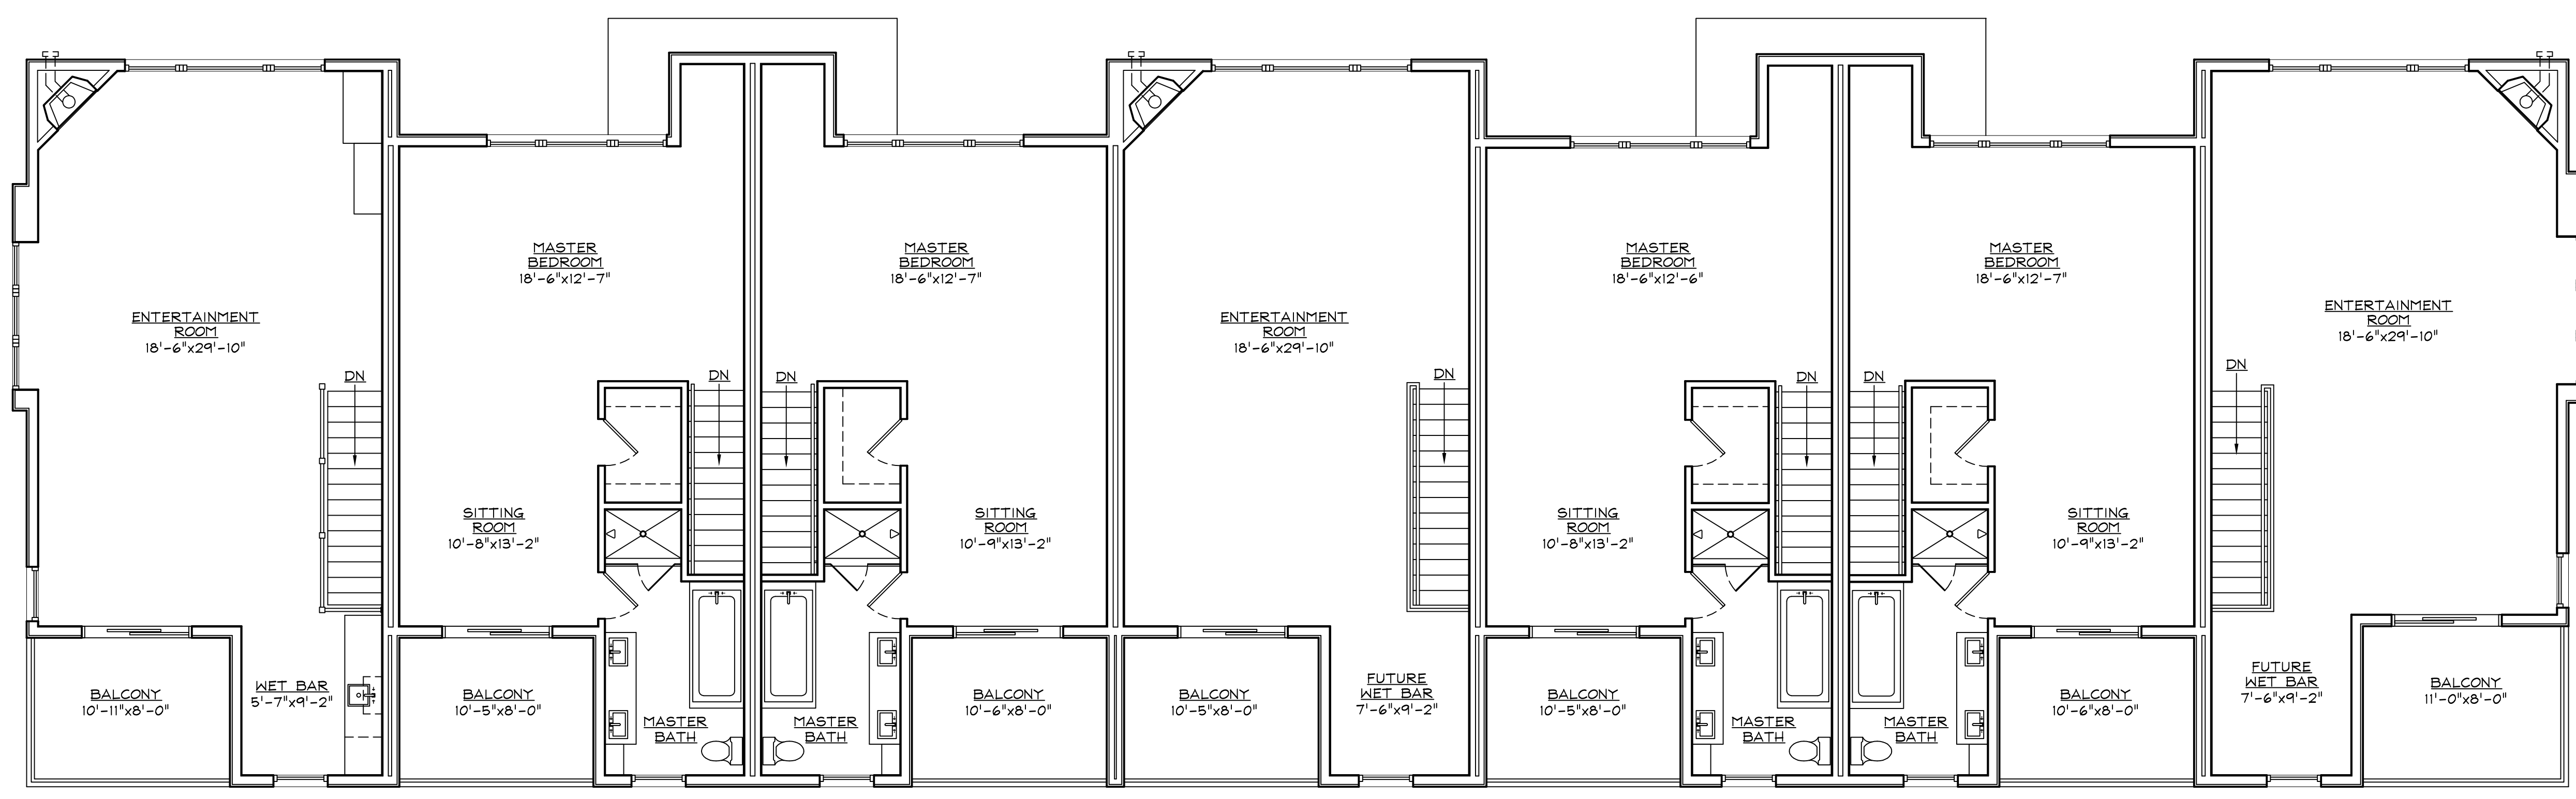

② THIRD LEVEL FLOOR PLAN
SCALE: 3/16" = 1'-0"

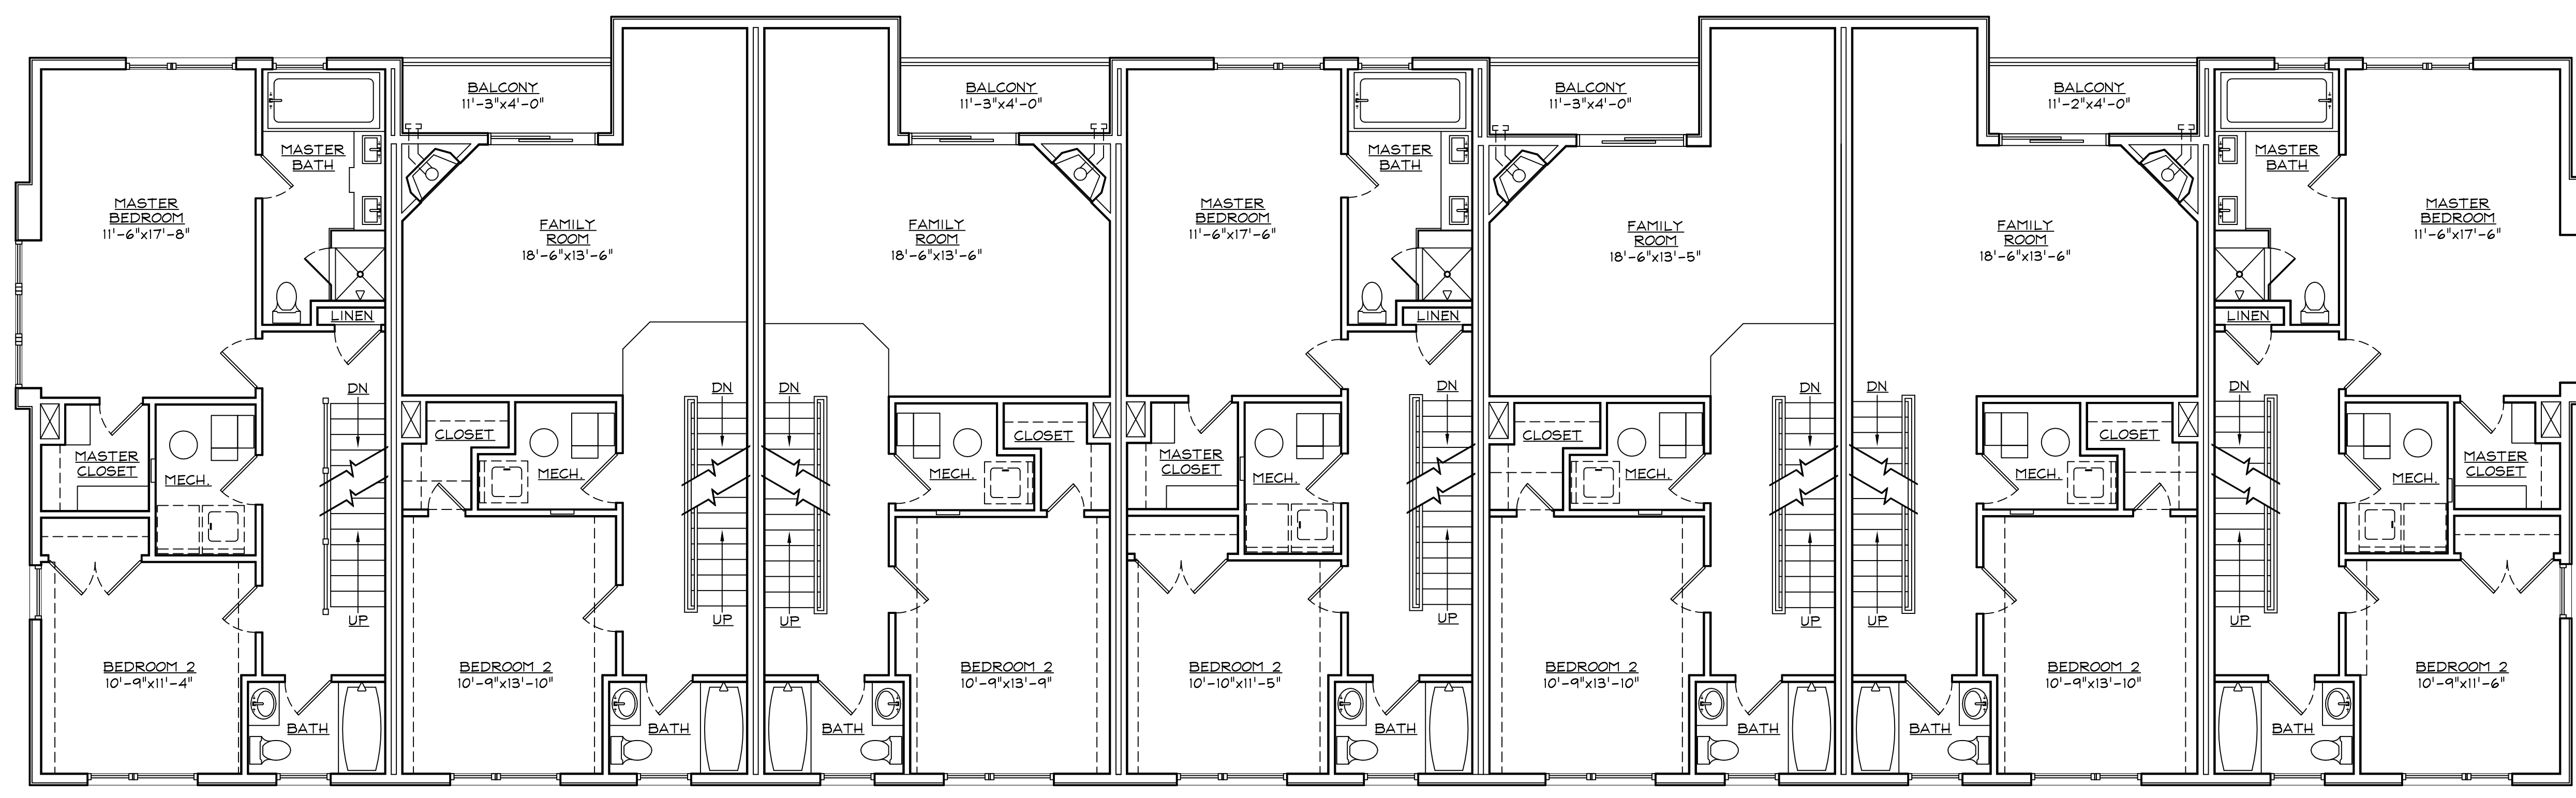

① SECOND LEVEL FLOOR PLAN
SCALE: 3/16" = 1'-0"