


UNIT G: FIRST LEVEL FLOORPLAN
SCALE: 3/16" = 1'-0"


KEY PLAN:
FIRST LEVEL

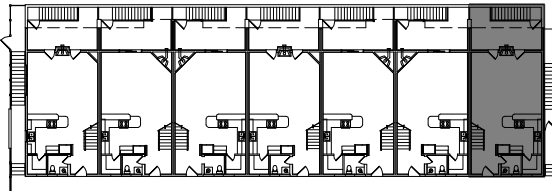

SQUARE FOOTAGE SUMMARY

| | |
|---------------------|---------|
| FIRST LEVEL: | 656 SF |
| SECOND LEVEL: | 741 SF |
| THIRD LEVEL: | 648 SF |
| TOTAL LIVING: | 2045 SF |
| 2-CAR GARAGE STALL: | 401 SF |
| PATIOS / BALCONIES: | 262 SF |

NOTE: TOTAL LIVING SQUARE FOOTAGE BASED ON THE ADDITION OF THE GROSS SQUARE FOOTAGE OF EACH FLOOR AND IS CALCULATED FROM THE EXTERIOR MOST WALL SURFACE TO THE CENTERLINE OF EACH PARTY WALL.

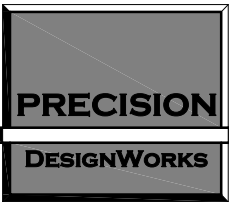

PRECISION DESIGNWORKS, LLC.
4265 HAWTHORNE DRIVE
BROOMFIELD, COLORADO 80020
T: 303.819.1833

NOTICE: DUTY OF COOPERATION
Release of these plans contemplates further cooperation among the owner, his contractor and the architect. Design and construction are complex. Although the architect and his consultants have performed their services with due care and diligence, they cannot guarantee perfection. Communication is imperfect, and every contingency cannot be anticipated. Any ambiguity or discrepancy discovered by the use of these plans shall be reported immediately to the architect. Failure to notify the architect compounds misunderstanding and increases construction costs. A failure to cooperate by a simple notice to the architect shall relieve the architect from responsibility for all consequences. Changes made from the plans without consent of the architect are unauthorized, and shall relieve the architect of responsibility for all consequences arising out of such changes.

All drawn and written information appearing herein shall not be duplicated, disclosed or otherwise used without the written consent of Precision DesignWorks, LLC.

3040 ZUNI STREET
TOWNHOMES
DENVER, CO 80211
AS-BUILT DOCUMENTATION

CURRENT ISSUE
AS-BUILTS - 02/22/2010

UNIT G
0 1/2 1 2

PROJECT NUMBER
0906

SHEET TITLE



UNIT G:
FIRST LEVEL
FLOORPLAN

©2010 PRECISION DESIGNWORKS, LLC.

SHEET NUMBER

G-1

FEBRUARY 22, 2010

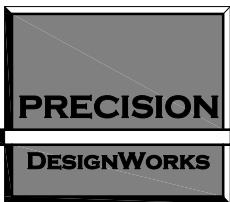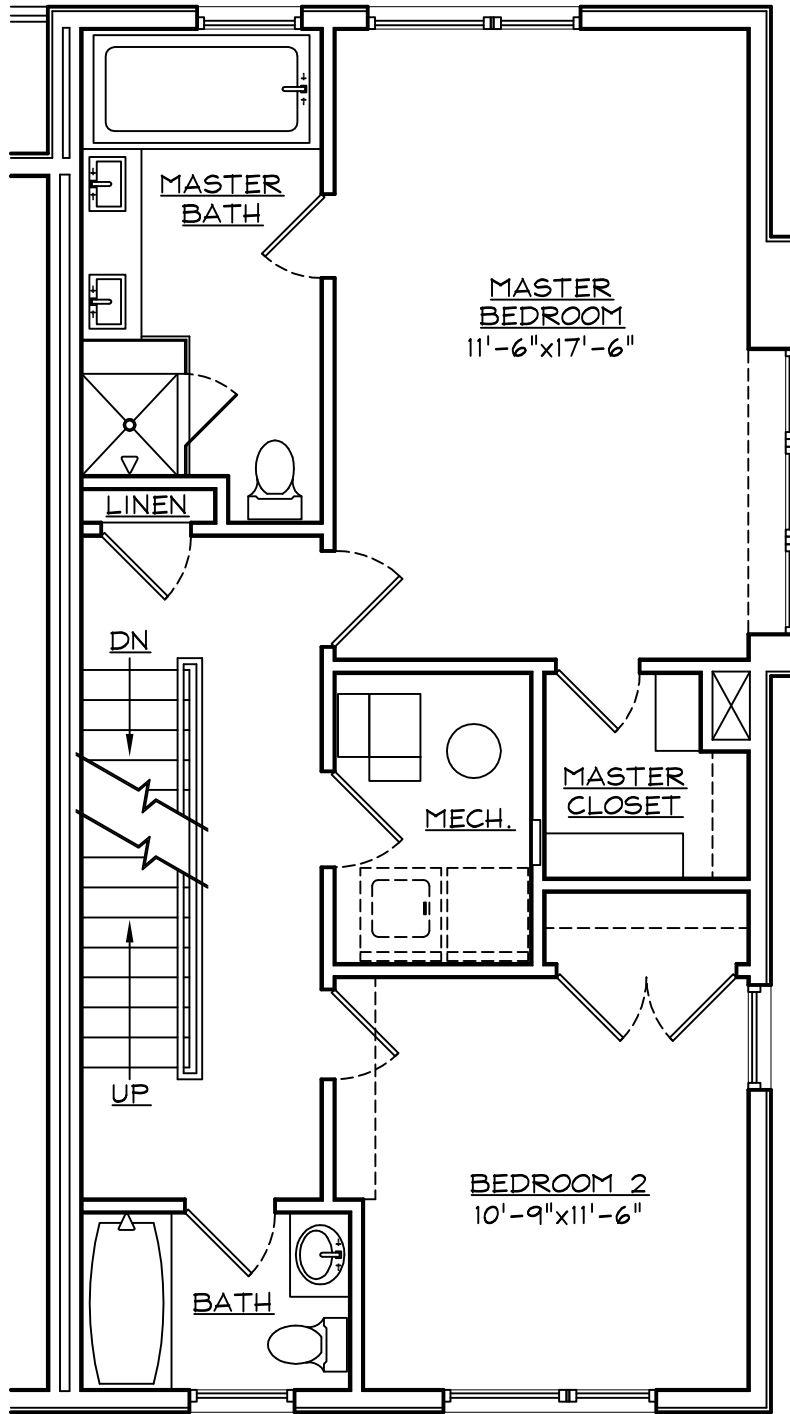

PRECISION DESIGNWORKS, LLC.
 4265 HAWTHORNE DRIVE
 BROOMFIELD, COLORADO 80020
 T: 303.819.1833

NOTICE: DUTY OF COOPERATION
 Release of these plans contemplates further cooperation among the owner, his contractor and the architect. Design and construction are complex. Although the architect and his consultants have performed their services with due care and diligence, they cannot guarantee perfection. Communication is imperfect, and every contingency cannot be anticipated. Any ambiguity or discrepancy discovered by the use of these plans shall be reported immediately to the architect. Failure to notify the architect compounds misunderstanding and increases construction costs. A failure to cooperate by a simple notice to the architect shall relieve the architect from responsibility for all consequences. Changes made from the plans without consent of the architect are unauthorized, and shall relieve the architect of responsibility for all consequences arising out of such changes.

All drawn and written information appearing herein shall not be duplicated, disclosed or otherwise used without the written consent of Precision DesignWorks, LLC.

3040 ZUNI STREET
 TOWNHOMES
 DENVER, CO 80211
 AS-BUILT DOCUMENTATION

CURRENT ISSUE
 AS-BUILTS - 02/22/2010



PROJECT NUMBER
 0906

SHEET TITLE
 UNIT G:
 SECOND LEVEL
 FLOORPLAN

©2010 PRECISION DESIGNWORKS, LLC.


SHEET NUMBER

G-2

FEBRUARY 22, 2010

UNIT G: SECOND LEVEL FLOORPLAN
 SCALE: 3/16" = 1'-0"


KEY PLAN:
 SECOND LEVEL

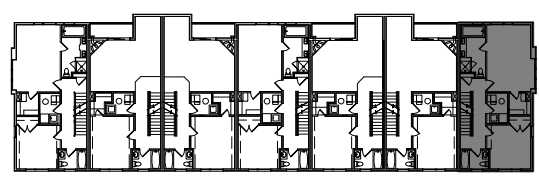

SQUARE FOOTAGE SUMMARY

| | |
|---------------------|---------|
| FIRST LEVEL: | 656 SF |
| SECOND LEVEL: | 741 SF |
| THIRD LEVEL: | 648 SF |
| TOTAL LIVING: | 2045 SF |
| 2-CAR GARAGE STALL: | 401 SF |
| PATIOS / BALCONIES: | 262 SF |

NOTE: TOTAL LIVING SQUARE FOOTAGE BASED ON THE ADDITION OF THE GROSS SQUARE FOOTAGE OF EACH FLOOR AND IS CALCULATED FROM THE EXTERIOR MOST WALL SURFACE TO THE CENTERLINE OF EACH PARTY WALL.

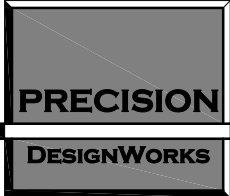


PRECISION DESIGNWORKS, LLC.
 4265 HAWTHORNE DRIVE
 BROOMFIELD, COLORADO 80020
 T: 303.819.1833

NOTICE: DUTY OF COOPERATION
 Release of these plans contemplates further cooperation among the owner, his contractor and the architect. Design and construction are complex. Although the architect and his consultants have performed their services with due care and diligence, they cannot guarantee perfection. Communication is imperfect, and every contingency cannot be anticipated. Any ambiguity or discrepancy discovered by the use of these plans shall be reported immediately to the architect. Failure to notify the architect compounds misunderstanding and increases construction costs. A failure to cooperate by a simple notice to the architect shall relieve the architect from responsibility for all consequences. Changes made from the plans without consent of the architect are unauthorized, and shall relieve the architect of responsibility for all consequences arising out of such changes.

All drawn and written information appearing herein shall not be duplicated, disclosed or otherwise used without the written consent of Precision DesignWorks, LLC.

3040 ZUNI STREET
 TOWNHOMES
 DENVER, CO 80211
 AS-BUILT DOCUMENTATION

CURRENT ISSUE
 AS-BUILTS - 02/22/2010

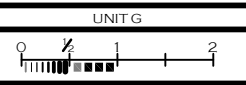


PROJECT NUMBER
 0906

SHEET TITLE
 UNIT G:
 THIRD LEVEL
 FLOORPLAN

©2010 PRECISION DESIGNWORKS, LLC.


SHEET NUMBER
G-3

FEBRUARY 22, 2010

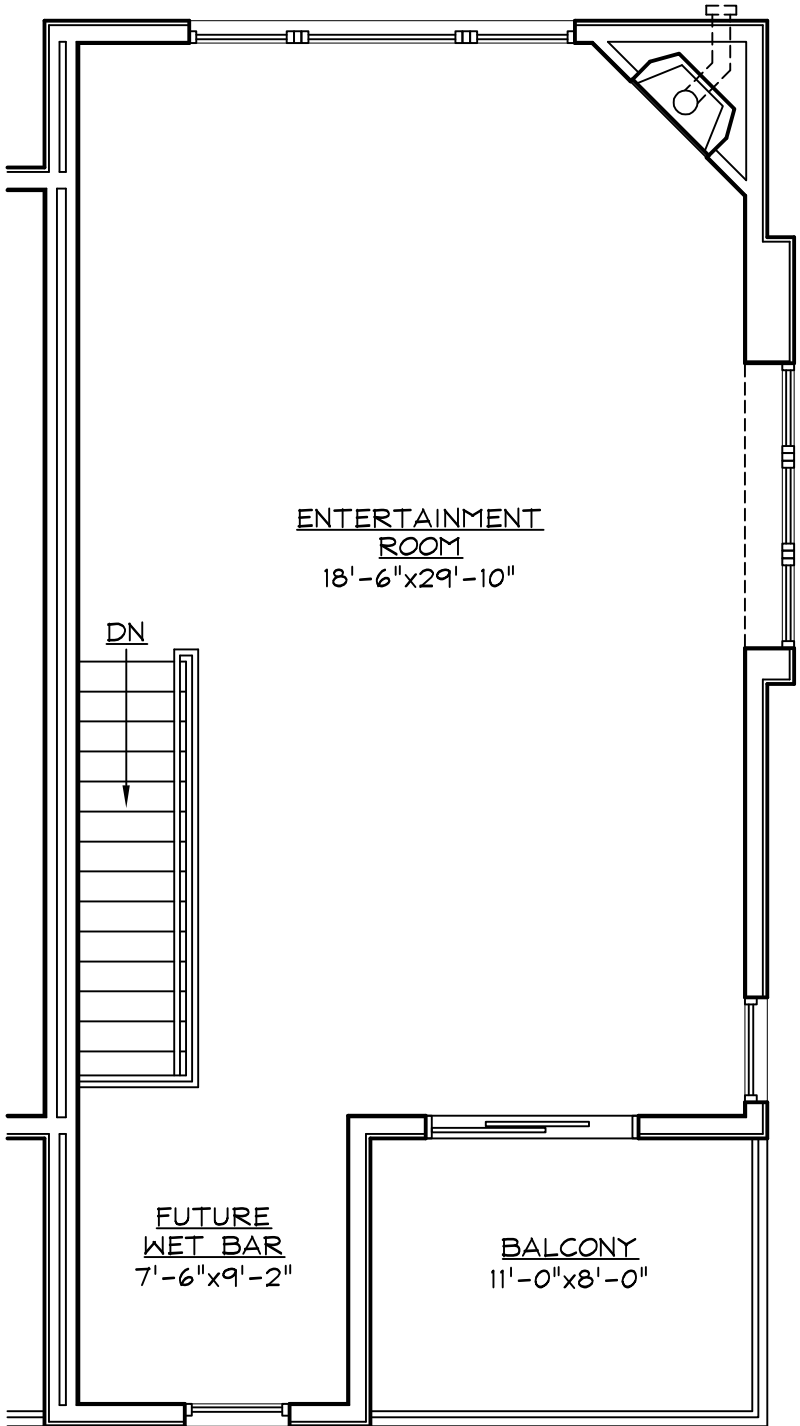

UNIT G: THIRD LEVEL FLOORPLAN
 SCALE: 3/16" = 1'-0"

KEY PLAN:
 THIRD LEVEL

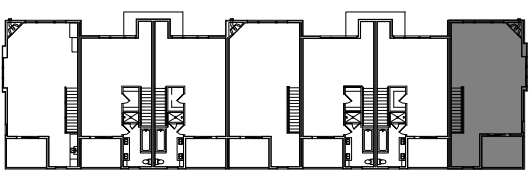

SQUARE FOOTAGE SUMMARY

| | |
|---------------------|---------|
| FIRST LEVEL: | 656 SF |
| SECOND LEVEL: | 741 SF |
| THIRD LEVEL: | 648 SF |
| TOTAL LIVING: | 2045 SF |
| 2-CAR GARAGE STALL: | 401 SF |
| PATIOS / BALCONIES: | 262 SF |

NOTE: TOTAL LIVING SQUARE FOOTAGE BASED ON THE ADDITION OF THE GROSS SQUARE FOOTAGE OF EACH FLOOR AND IS CALCULATED FROM THE EXTERIOR MOST WALL SURFACE TO THE CENTERLINE OF EACH PARTY WALL.